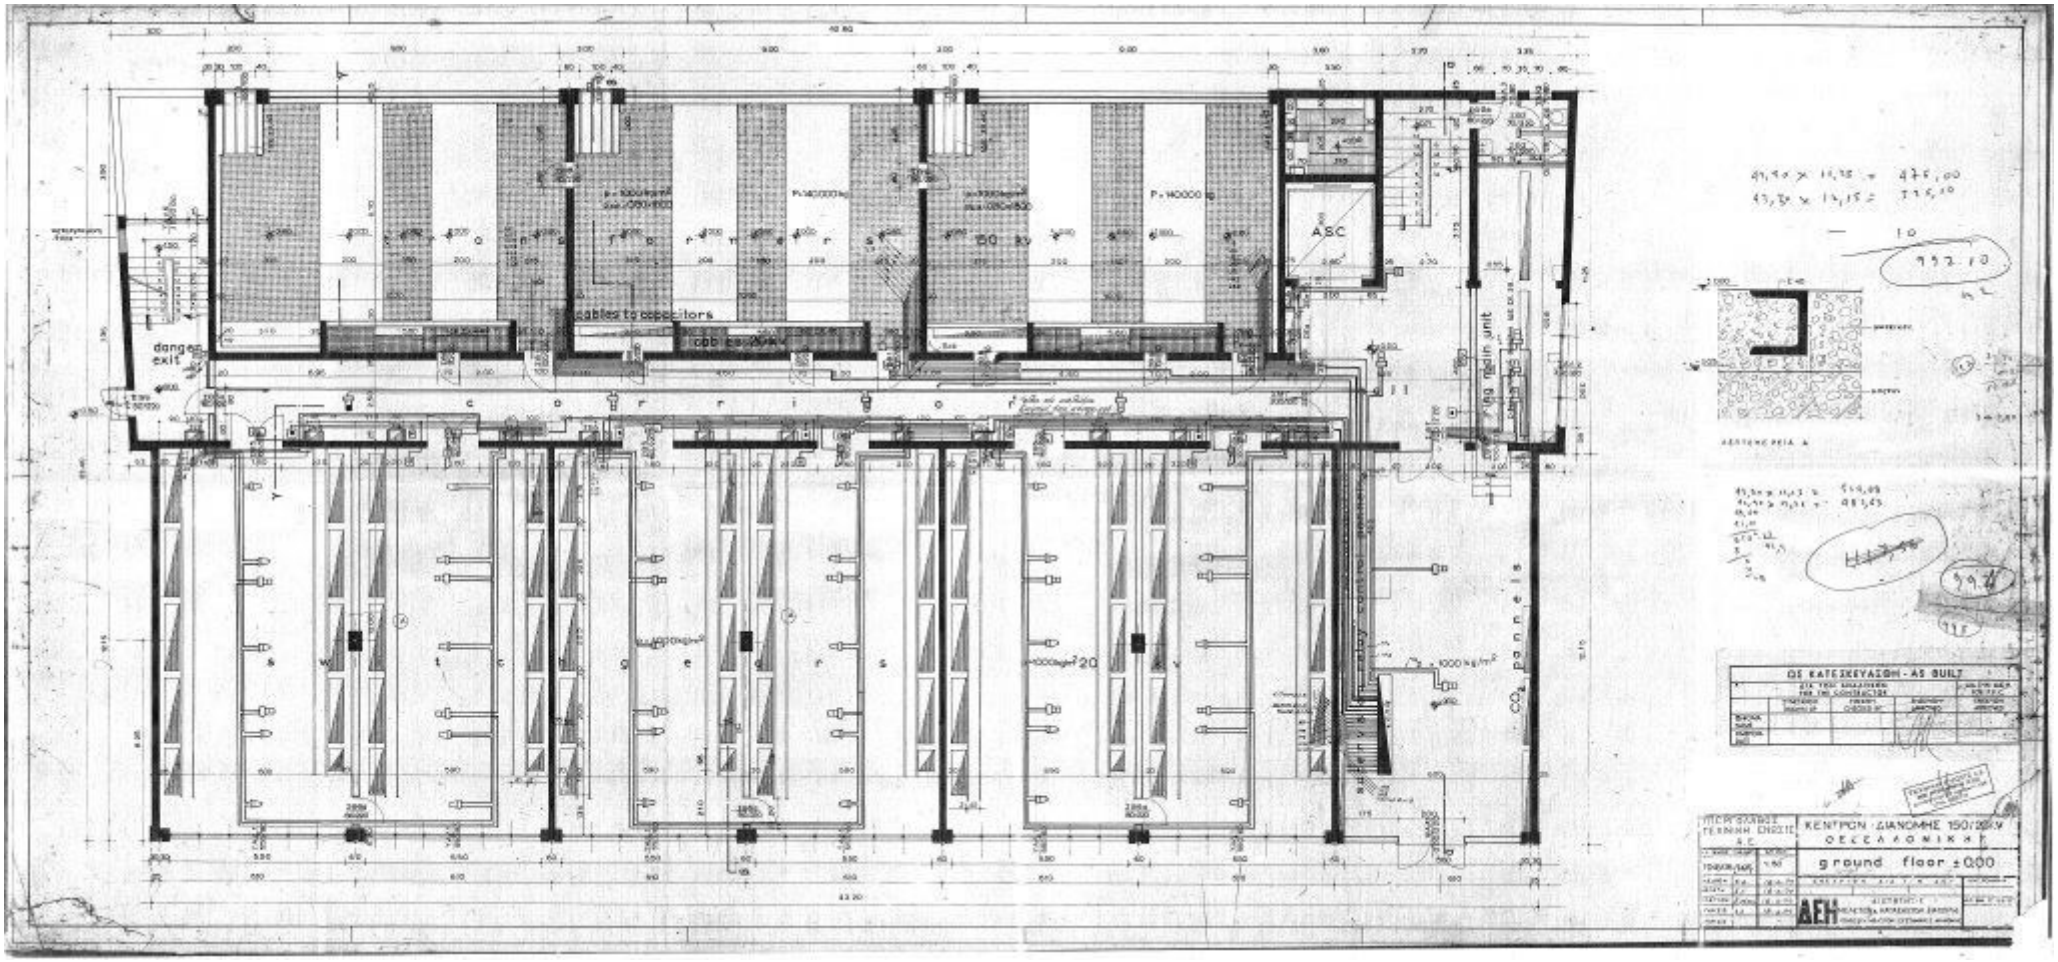
cables to capacitors
cables to ASC
danger exit
corridor
ASC
150 kV
P=140000 kg
P=140000 kg
P=140000 kg
switchgear
1000 kg/m²
20
CO2 panels
AS BUILT
ΚΕΝΤΡΟΝ ΔΙΑΝΟΜΗΣ 150/20 kV
ΘΕΣΣΑΛΟΝΙΚΗ
ground floor ±0.00
ΔΕΗ